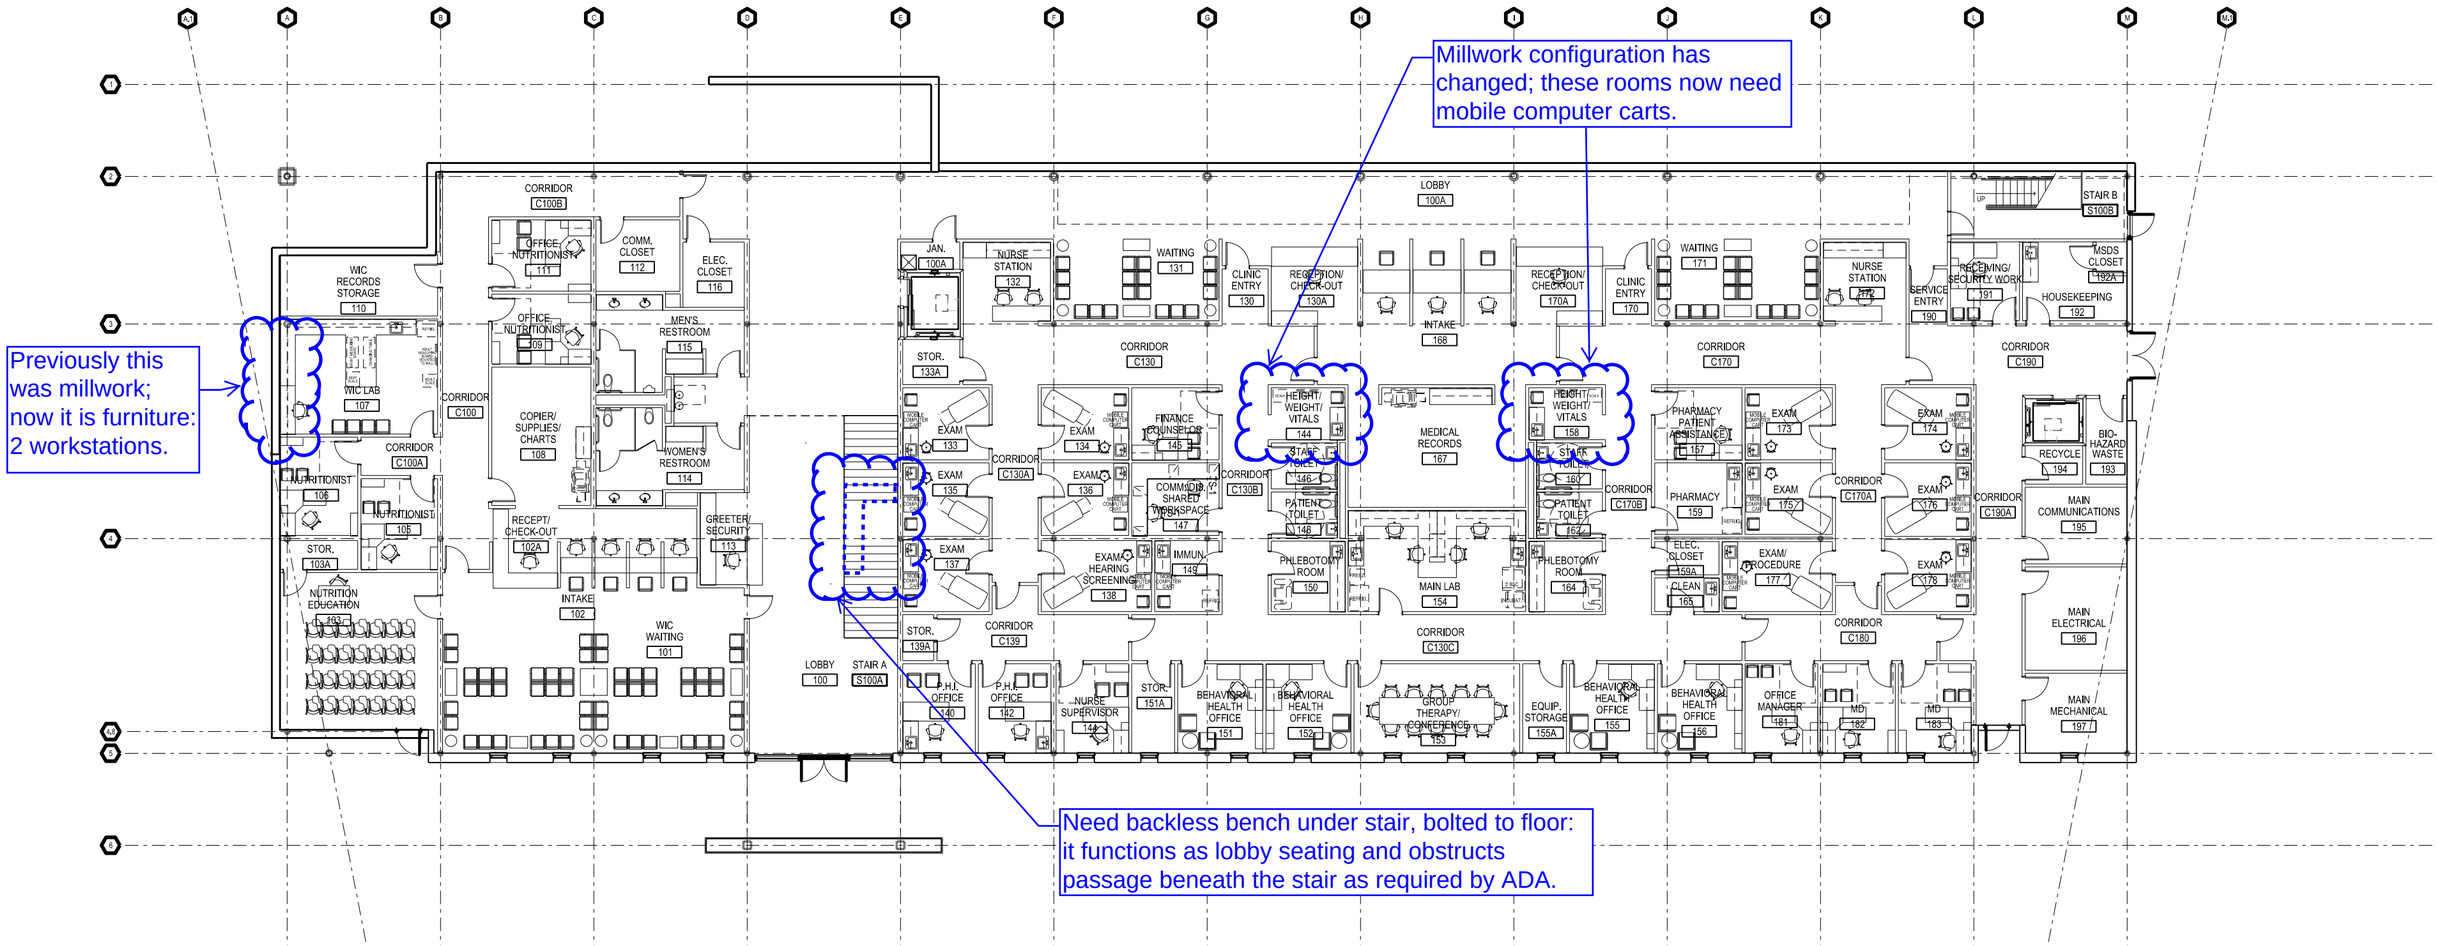

SBS Markups
12/14/11

Note: Refer to attached drawing 2A1, dated 12/8/11, for the most current floor plan and millwork configurations.

Scale: 1/8" = 1'-0"

FULTON COUNTY

Adamsville Regional Health Center

September 14, 2011

First Floor Plan

WHITING-TURNER

HERMOSA CONSTRUCTION

STANLEYBEAMAN&SEARS

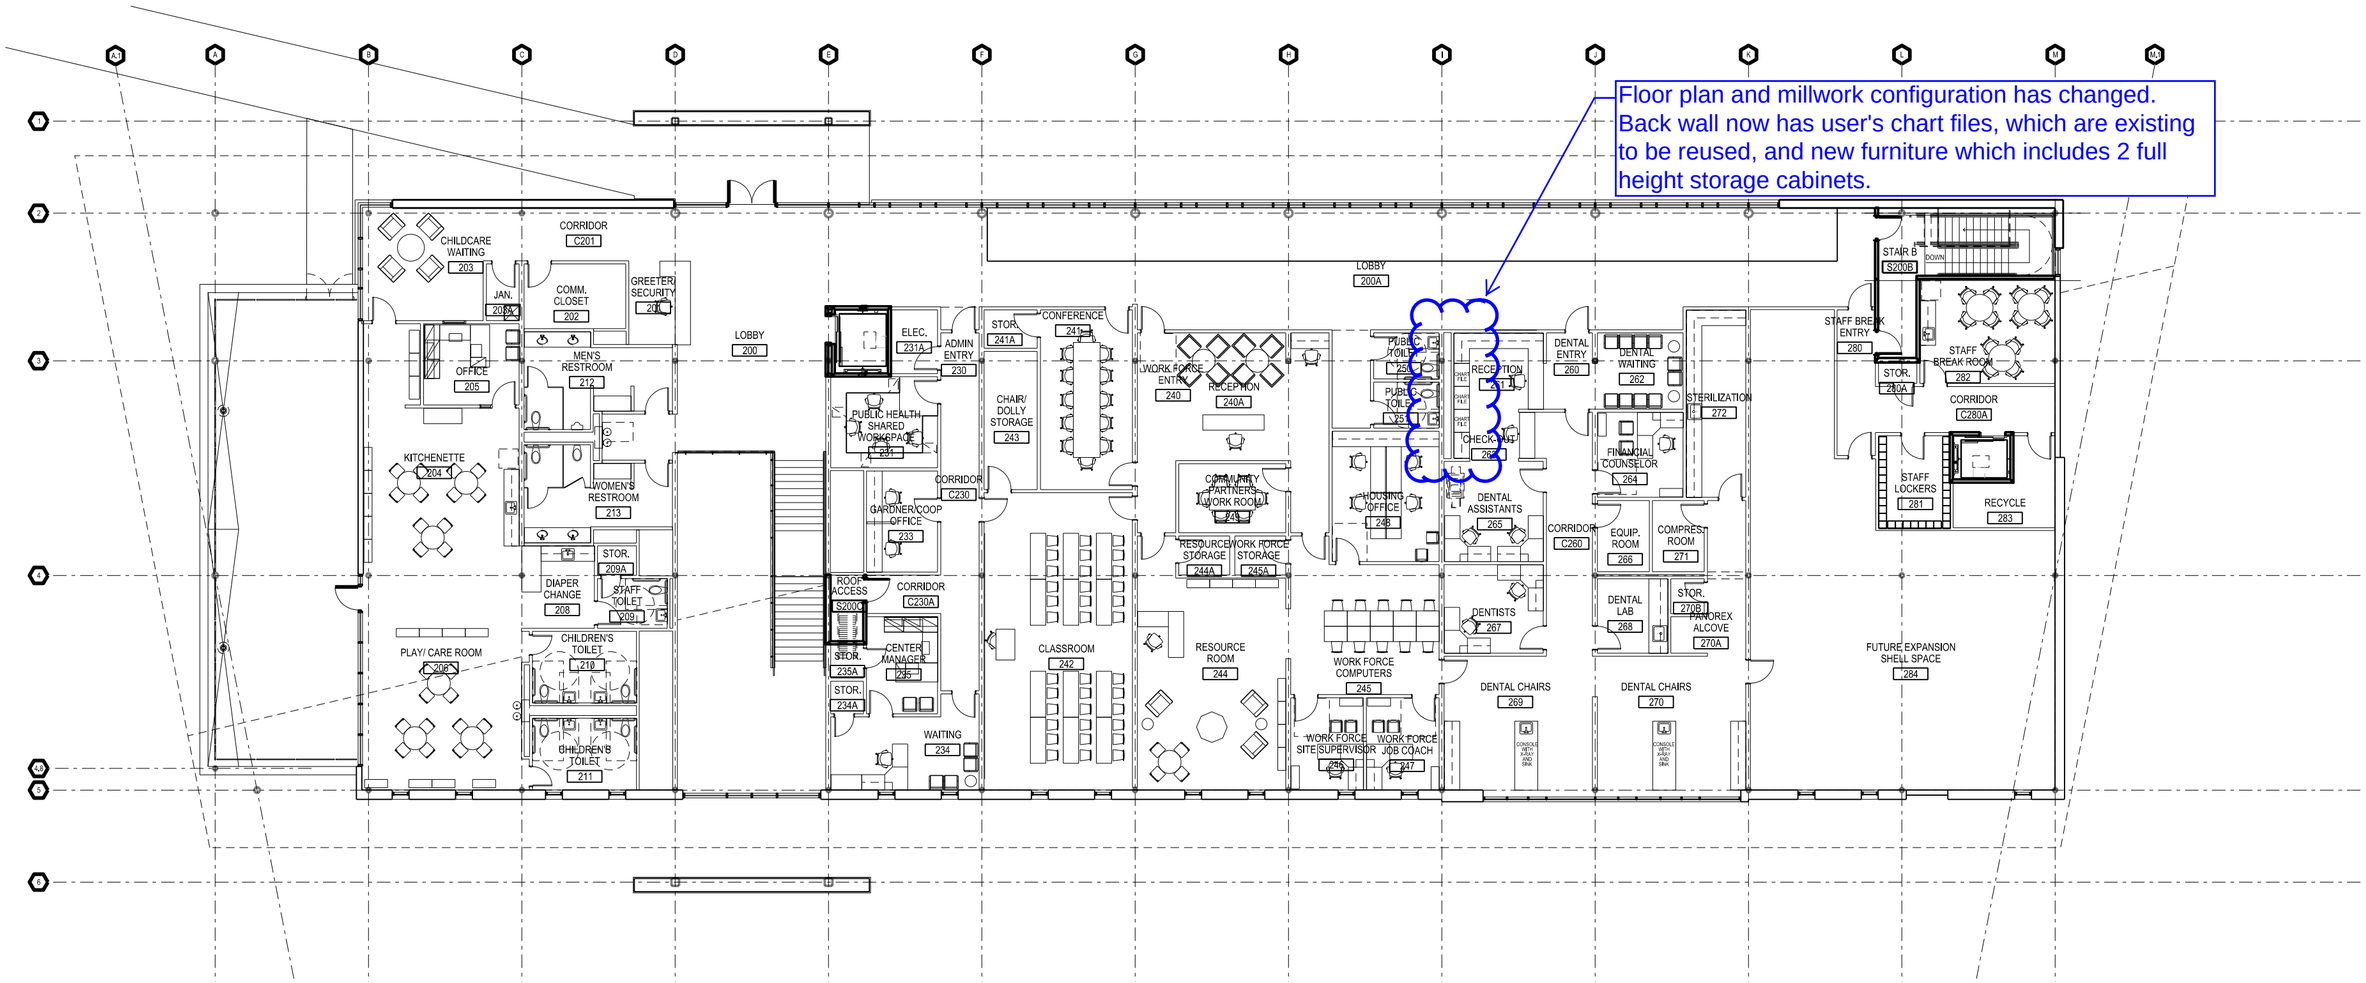

SBS Markups
12/14/11

Note: Refer to attached drawing 2A2, dated 12/8/11, for the most current floor plan and millwork configurations.

Scale: 1/8" = 1'-0"

FULTON COUNTY

Adamsville Regional Health Center

September 14, 2011

Second Floor Plan

WHITING-TURNER

HERMOSA CONSTRUCTION

STANLEYBEAMAN&SEARS

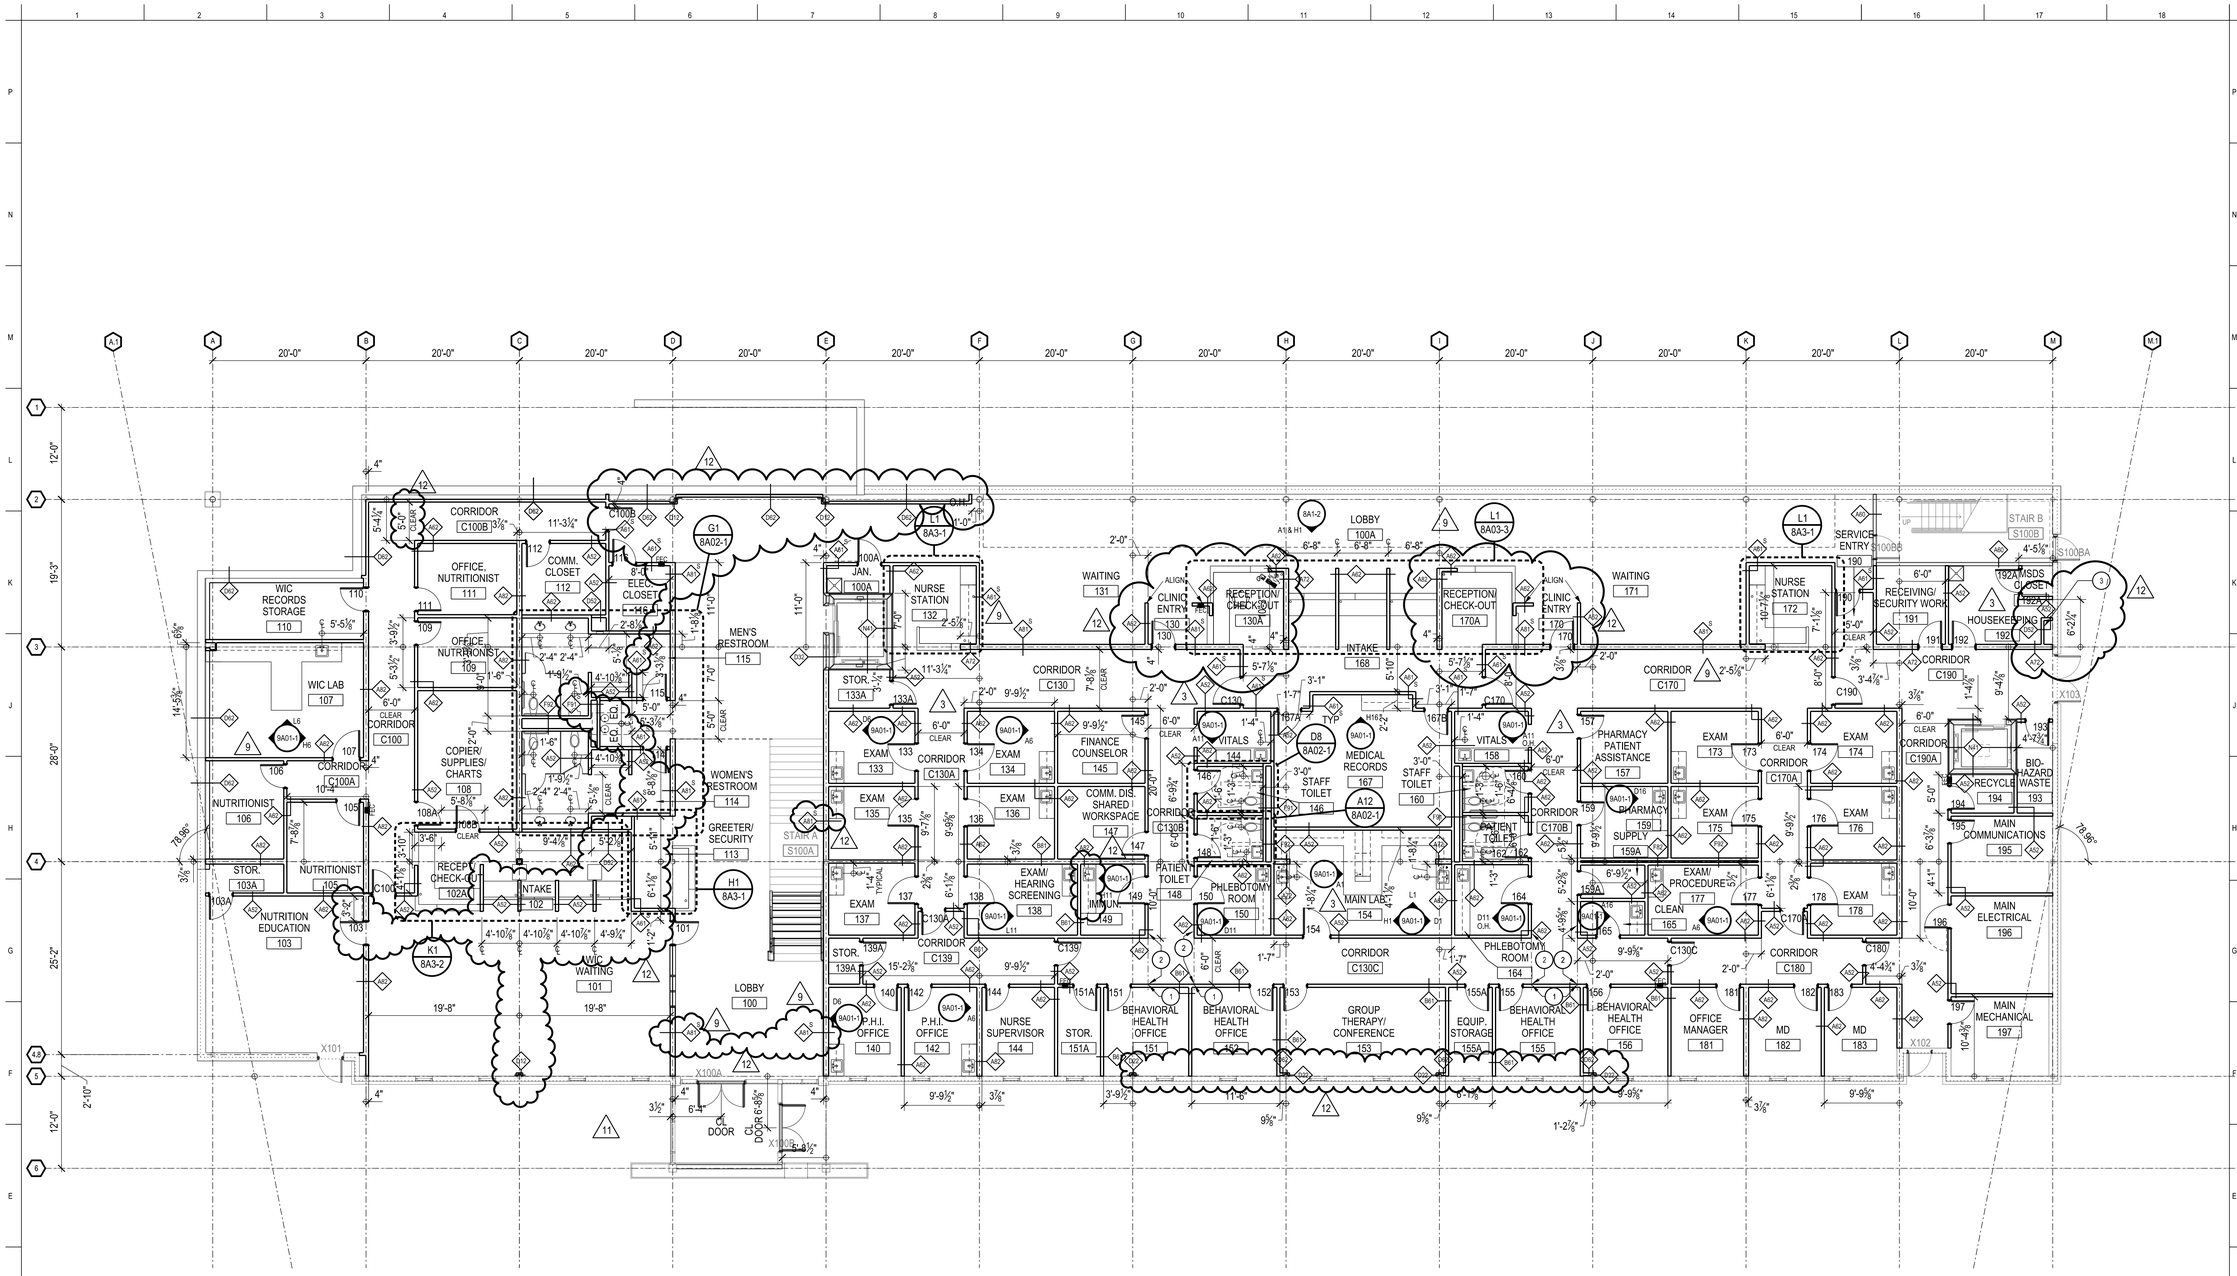

D1	First Floor Plan
2A01	1/8" = 1' 0"

GENERAL NOTES

1. ~~ROOM NUMBERS, DOOR NUMBER, WALL TYPES AND ADDITIONAL INTERIOR INFORMATION TO BE PROVIDED DURING INTERIOR FIT-UP ISSUANCE 10 /12 /2011.~~
2. TYPICAL DIMENSION FOR THE CENTERLINE OF SINK TO THE ADJACENT FINISH FACE OF WALL IS 1'-4" UNLESS DIMENSIONED OTHERWISE.
3. SEE SHEET 2A10-CS FOR ADDITIONAL CORE (EXTERIOR WALLS) AND SHELL (ELEVATORS, STAIRWAYS) INFORMATION.
4. FOR PARTION TYPE D62 ALONG COLUMN LINES A, 2.5, B, 2, SUBSTITUTE ACOUSTIC INSULATION WITH INSULATION TYPE NOTED ON WALL SECTIONS.
5. ALL PARTITIONS DESIGNATED AS TYPE "B" SHALL HAVE SECOND LAYER OF DRYWALL ON INSIDE OF ROOM UNLESS NOTED OTHERWISE.
6. COLUMNS LOCATED WITHIN INTERIOR WALLS ARE TO BE FULLY ENCLOSED. IN THE EVENT THAT A COLUMN PROTRUDES BEYOND THE WALL DUE TO FIELD CONDITIONS, THE ENTIRE WALL INSIDE THAT ROOM SHALL BE FURRED OUT TO ENCLOSE THE COLUMN UNLESS NOTED OTHERWISE. CLEAR CORRIDOR WIDTHS ARE TO BE MAINTAINED.

SHEET SPECIFIC NOTES

1. ANODIZED ALUMINUM REVEAL; REFER TO DETAIL F1 / 10A2-2
2. ALIGN
3. FURR OUT WALL TO ENCAPSULATE PIPING

WHITING-TURNER
HERMOSA CONSTRUCTION
STANLEY BEAMAN & SEARS
180 Peachtree Street NW,
Suite 600
Atlanta, GA 30303
t 404.524.2200
f 404.524.8610
www.stanleybeamansears.com

CONSULTANTS

EBERLY & ASSOCIATES
Civil Engineering & Landscape Architecture
Atlanta, GA
770.452.7849

UZUN & CASE
Structural Engineering
Atlanta, GA
678.553.5200

JOHNSON SPELLMAN & ASSOCIATES
Mechanical, Plumbing Engineering
Atlanta, GA
678.336.5412

BARNETT CONSULTING ENGINEERS
Electrical Engineering
Atlanta, GA
770.447.1495

SEAL

Copyright ©2010 by Stanley Beaman & Sears, Inc. All rights reserved. This document is the property of Stanley Beaman & Sears, Inc. It is to be used only for the specific project identified or referred to herein and is not to be used on other projects or extensions to this project, in whole or in part, except by express written agreement with Stanley Beaman & Sears, Inc.

PROJECT DATA

FULTON COUNTY

ADAMSVILLE REGIONAL HEALTH CENTER
3700 Martin Luther King Jr. Drive, SW
Atlanta, GA 30331

KEY PLAN

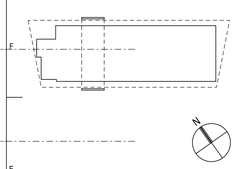

ISSUANCE AND DATE

	Preliminary Interior Wall Layout	09/13/2011
1	Revision to Interior Wall Layout	09/26/2011
2	INTERIOR FIT-UP ISSUANCE	10/12/2011
3	GENERAL REVISIONS #4	10/28/2011
4	GENERAL REVISIONS #5	11/21/2011
5	GENERAL REVISIONS #6	12/08/2011

SHEET INFORMATION

ORIGINAL ISSUE	SEPTEMBER 13, 2011
JOB NUMBER	11261
DRAWN	
CHECKED	
APPROVED	

First Floor Plan
Interior Architecture

2A01

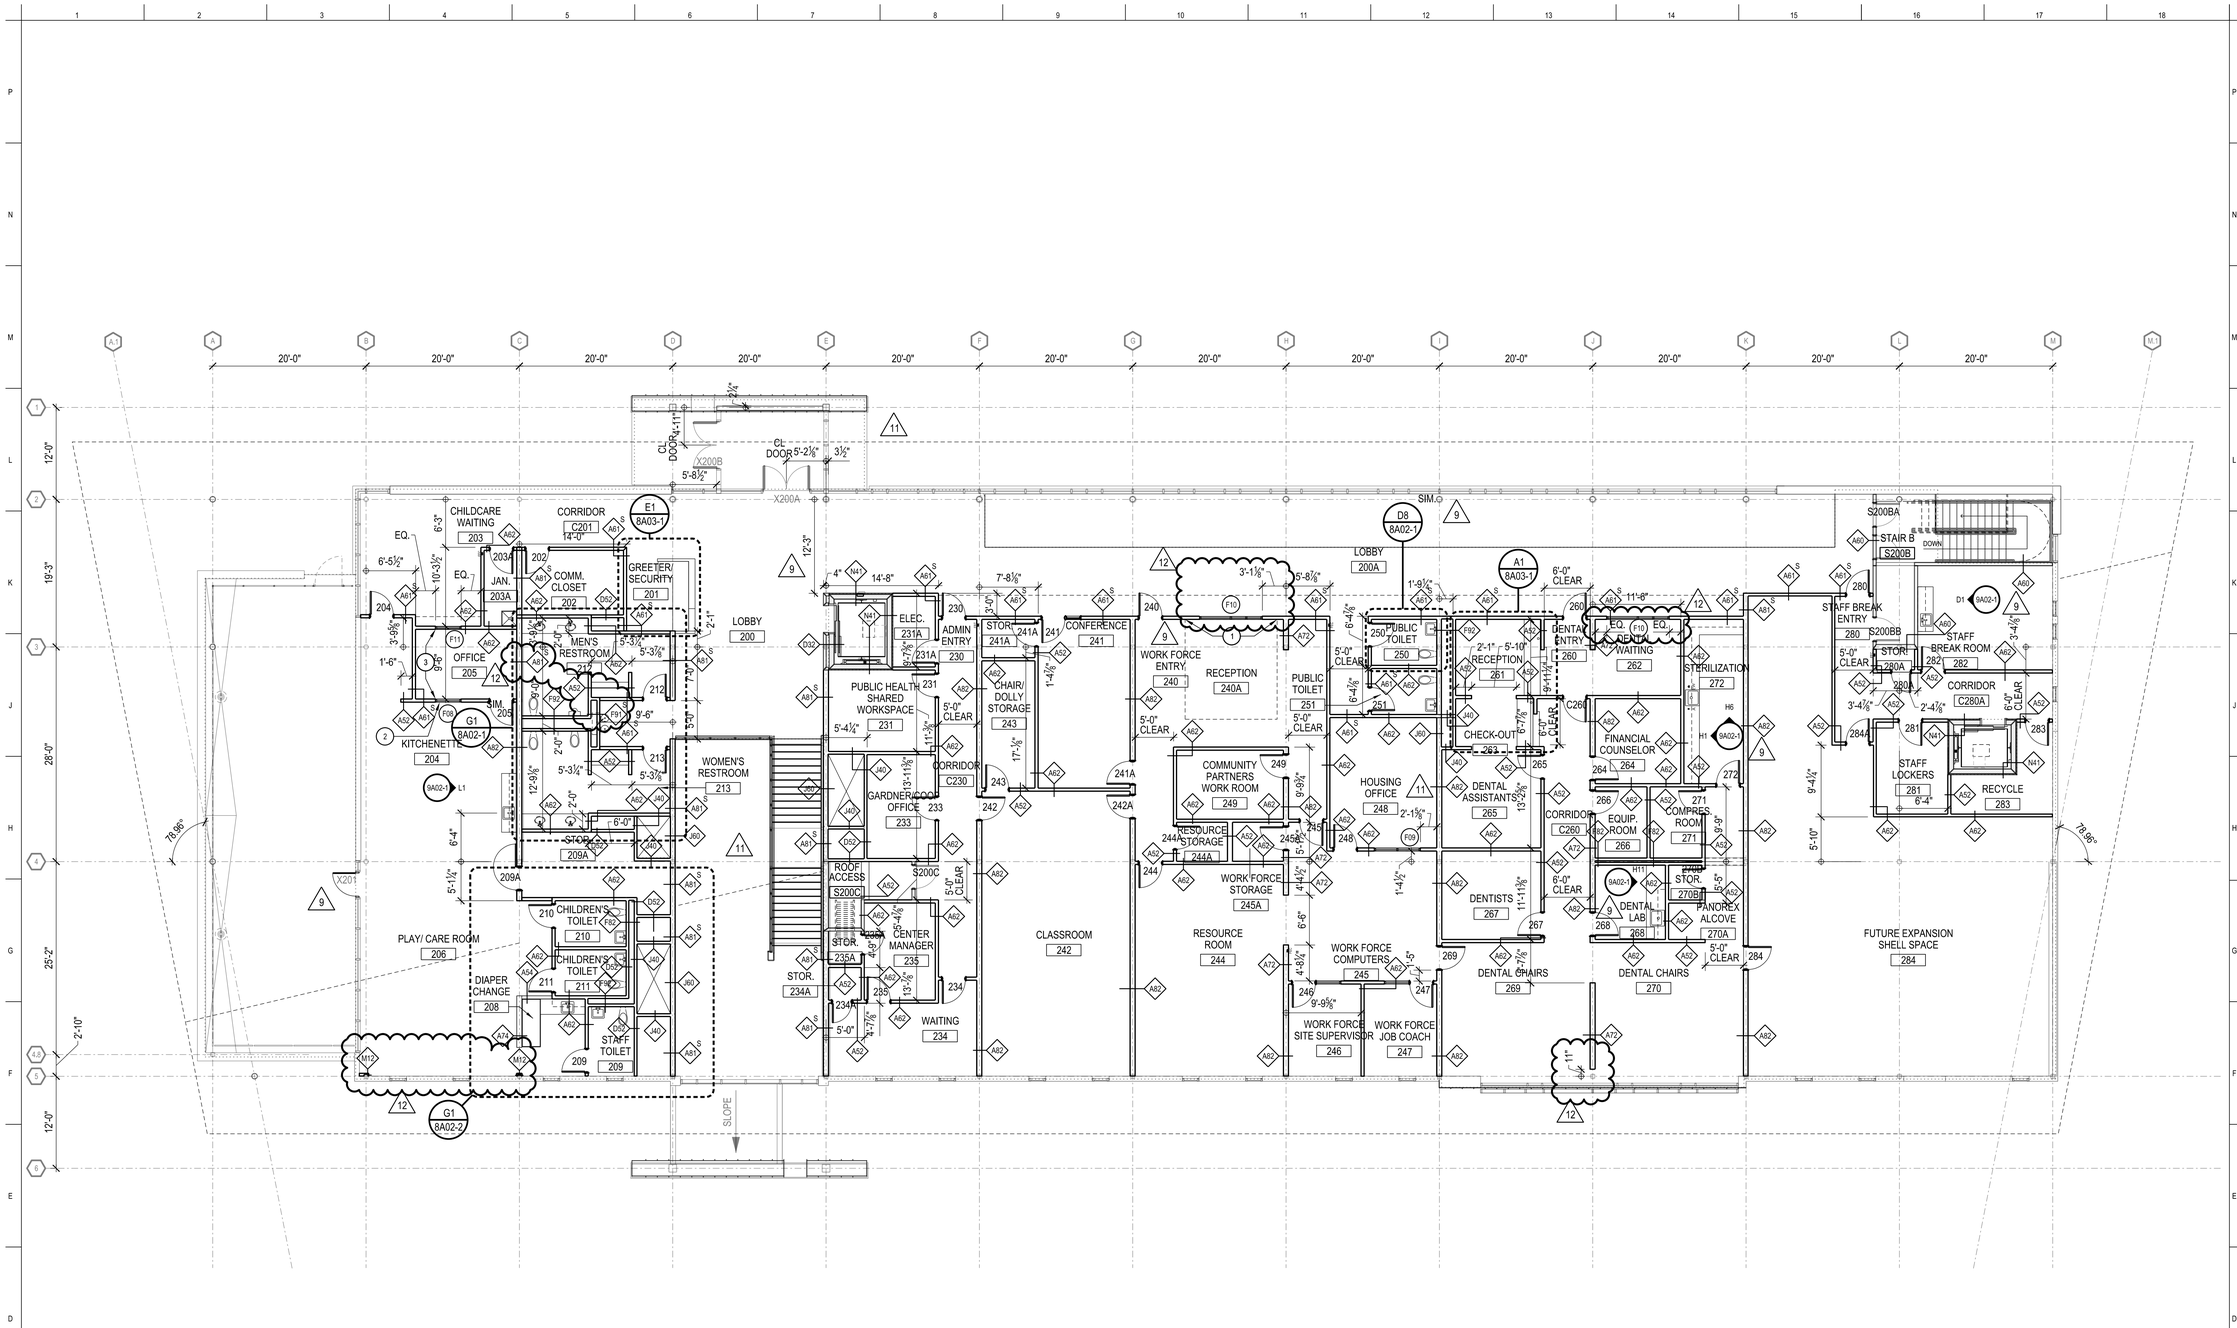

D1	Second Floor Plan
2A02	1/8" = 1' 0"

GENERAL NOTES

1. ~~ROOM NUMBERS, DOOR NUMBER, WALL TYPES AND ADDITIONAL INTERIOR INFORMATION TO BE PROVIDED DURING INTERIOR FIT-UP ISSUANCE 10 /12 /2011.~~
2. TYPICAL DIMENSION FOR THE CENTERLINE OF SINK TO THE ADJACENT FINISH FACE OF WALL IS 1'-4" UNLESS DIMENSIONED OTHERWISE.
3. SEE SHEET 2A20-CS FOR ADDITIONAL CORE (EXTERIOR WALLS) AND SHELL (ELEVATORS, STAIRWAYS) INFORMATION.
4. ALL PARTITIONS DESIGNATED AS TYPE "B" SHALL HAVE SECOND LAYER OF DRYWALL ON INSIDE OF ROOM UNLESS NOTED OTHERWISE.
5. COLUMNS LOCATED WITHIN INTERIOR WALLS ARE TO BE FULLY ENCLOSED. IN THE EVENT THAT A COLUMN PROTRUDES BEYOND THE WALL DUE TO FIELD CONDITIONS, THE ENTIRE WALL INSIDE THAT ROOM SHALL BE FURRED OUT TO ENCLOSE THE COLUMN UNLESS NOTED OTHERWISE. CLEAR CORRIDOR WIDTHS ARE TO BE MAINTAINED.

SHEET SPECIFIC NOTES

1. ANODIZED ALUMINUM REVEAL; REFER TO DETAIL F1 / 10A2-2; ALIGN WITH EDGE OF GYPSUM CEILING ABOVE
2. MIRROR SIDE OF ONE-WAY MIRROR GLAZING
3. ALIGN

WHITING-TURNER
HERMOSA CONSTRUCTION
STANLEY BEAMAN & SEARS
180 Peachtree Street NW, Suite 600
Atlanta, GA 30303
t 404.524.2200
f 404.524.8610
www.stanleybeamansears.com

CONSULTANTS

EBERLY & ASSOCIATES
Civil Engineering & Landscape Architecture
Atlanta, GA
770.452.7849

UZUN & CASE
Structural Engineering
Atlanta, GA
678.553.5200

JOHNSON SPELLMAN & ASSOCIATES
Mechanical, Plumbing Engineering
Atlanta, GA
678.336.5412

BARNETT CONSULTING ENGINEERS
Electrical Engineering
Atlanta, GA
770.447.1495

SEAL

Copyright ©2010 by Stanley Beaman & Sears, Inc. All rights reserved. This document is the property of Stanley Beaman & Sears, Inc. It is to be used only for the specific project identified or referred to herein and is not to be used on other projects or extensions to this project, in whole or in part, except by express written agreement with Stanley Beaman & Sears, Inc.

PROJECT DATA

FULTON COUNTY

ADAMSVILLE REGIONAL HEALTH CENTER
3700 Martin Luther King Jr. Drive, SW
Atlanta, GA 30331

KEY PLAN

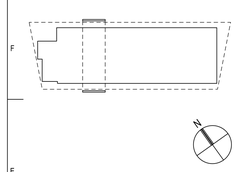

ISSUANCE AND DATE

4	GENERAL REVISIONS #4	10/28/2011
5	GENERAL REVISIONS #5	11/21/2011
6	GENERAL REVISIONS #6	12/08/2011

SHEET INFORMATION

ORIGINAL ISSUE	OCTOBER 12, 2011
JOB NUMBER	11261
DRAWN	
CHECKED	
APPROVED	

Second Floor Plan
Interior Architecture

2A02